

<i>Rathlin Energy</i>	Applies To: Rathlin Energy	RE-05-EPRA-CH- SP-004
Prepared By: Jonathan Foster	Uncontrolled, If Printed	Rev: 1.00

EMS SUPPORTING DOCUMENTATION - EPRA – CRAWBERRY HILL EXPLORATORY OPERATIONS - SITE PLANS

Crawberry Hill Wellsite Site Plans Exploratory Operations

This document contains proprietary information belonging to Rathlin Energy (UK) Limited and shall be used only for the purpose for which it was supplied. It shall not be copied, reproduced, disclosed or otherwise used, nor shall such information be furnished in whole or in part to third parties, except in accordance with the terms of any agreement under which it was supplied or with the prior consent of Rathlin Energy (UK) Limited and shall be returned upon request.

© Copyright of Rathlin Energy (UK) Limited

Rev:	Prepared By:	Checked By:	Approved By:	Issued:
1.00	Jonathan Foster	Tom Selkirk	D Montagu-Smith	16/01/2014

<i>Rathlin Energy</i>	Applies To: Rathlin Energy	RE-05-EPRA-CH- SP-004
Prepared By: Jonathan Foster	Uncontrolled, If Printed	Rev: 1.00

EMS SUPPORTING DOCUMENTATION - EPRA – CRAWBERRY HILL EXPLORATORY OPERATIONS - SITE PLANS

*** Page Left Blank Intentionally ***

Rev:	Prepared By:	Checked By:	Approved By:	Issued:
1.00	Jonathan Foster	Tom Selkirk	D Montagu-Smith	16/01/2014



Key:

Site Boundary



Rathlin Energy (UK) Limited
8 Wimpole Street
London
W1G 9SP

Job Title:
Crawberry Hill Wellsite

Drawing Title:
Site Plan (Environmental &
Waste Management Plan)


Scale: 1:5,000 (Print A3)


Date: 16th January 2014

Drawn By:
Jonathan Foster



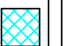


Drawing No:
RE-05-EPRA-CH-SP-004-01

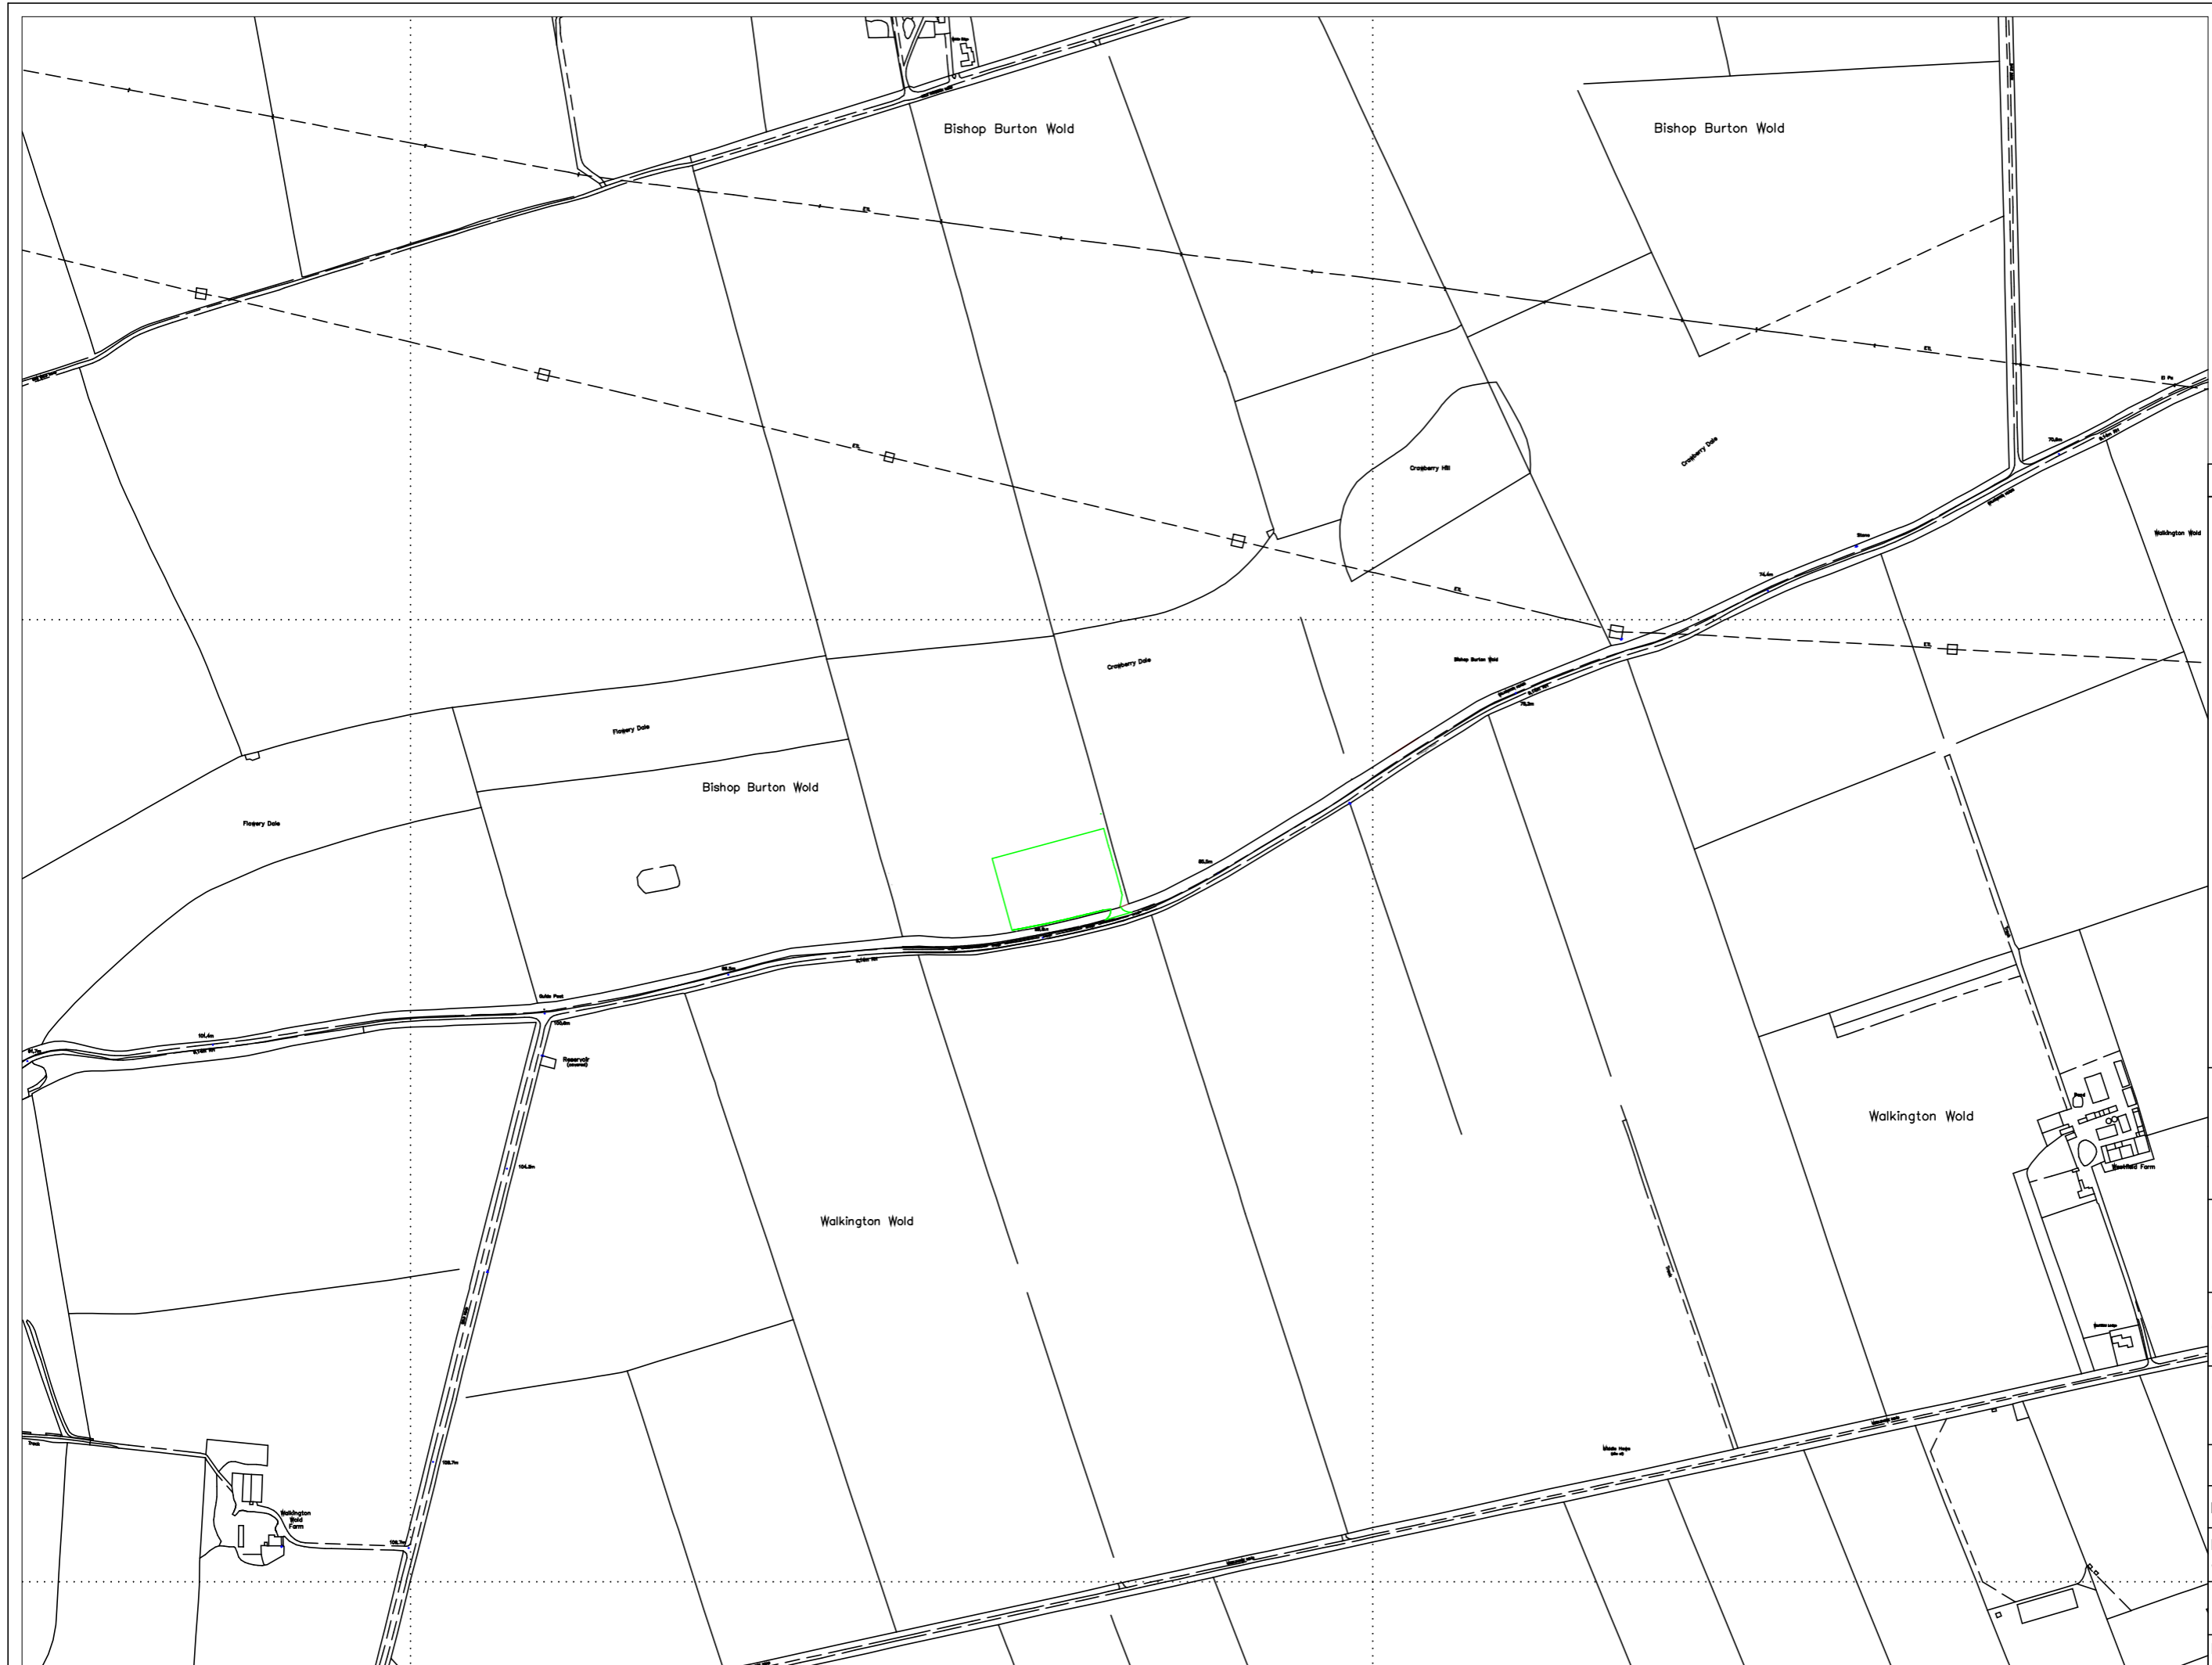Rev: 0

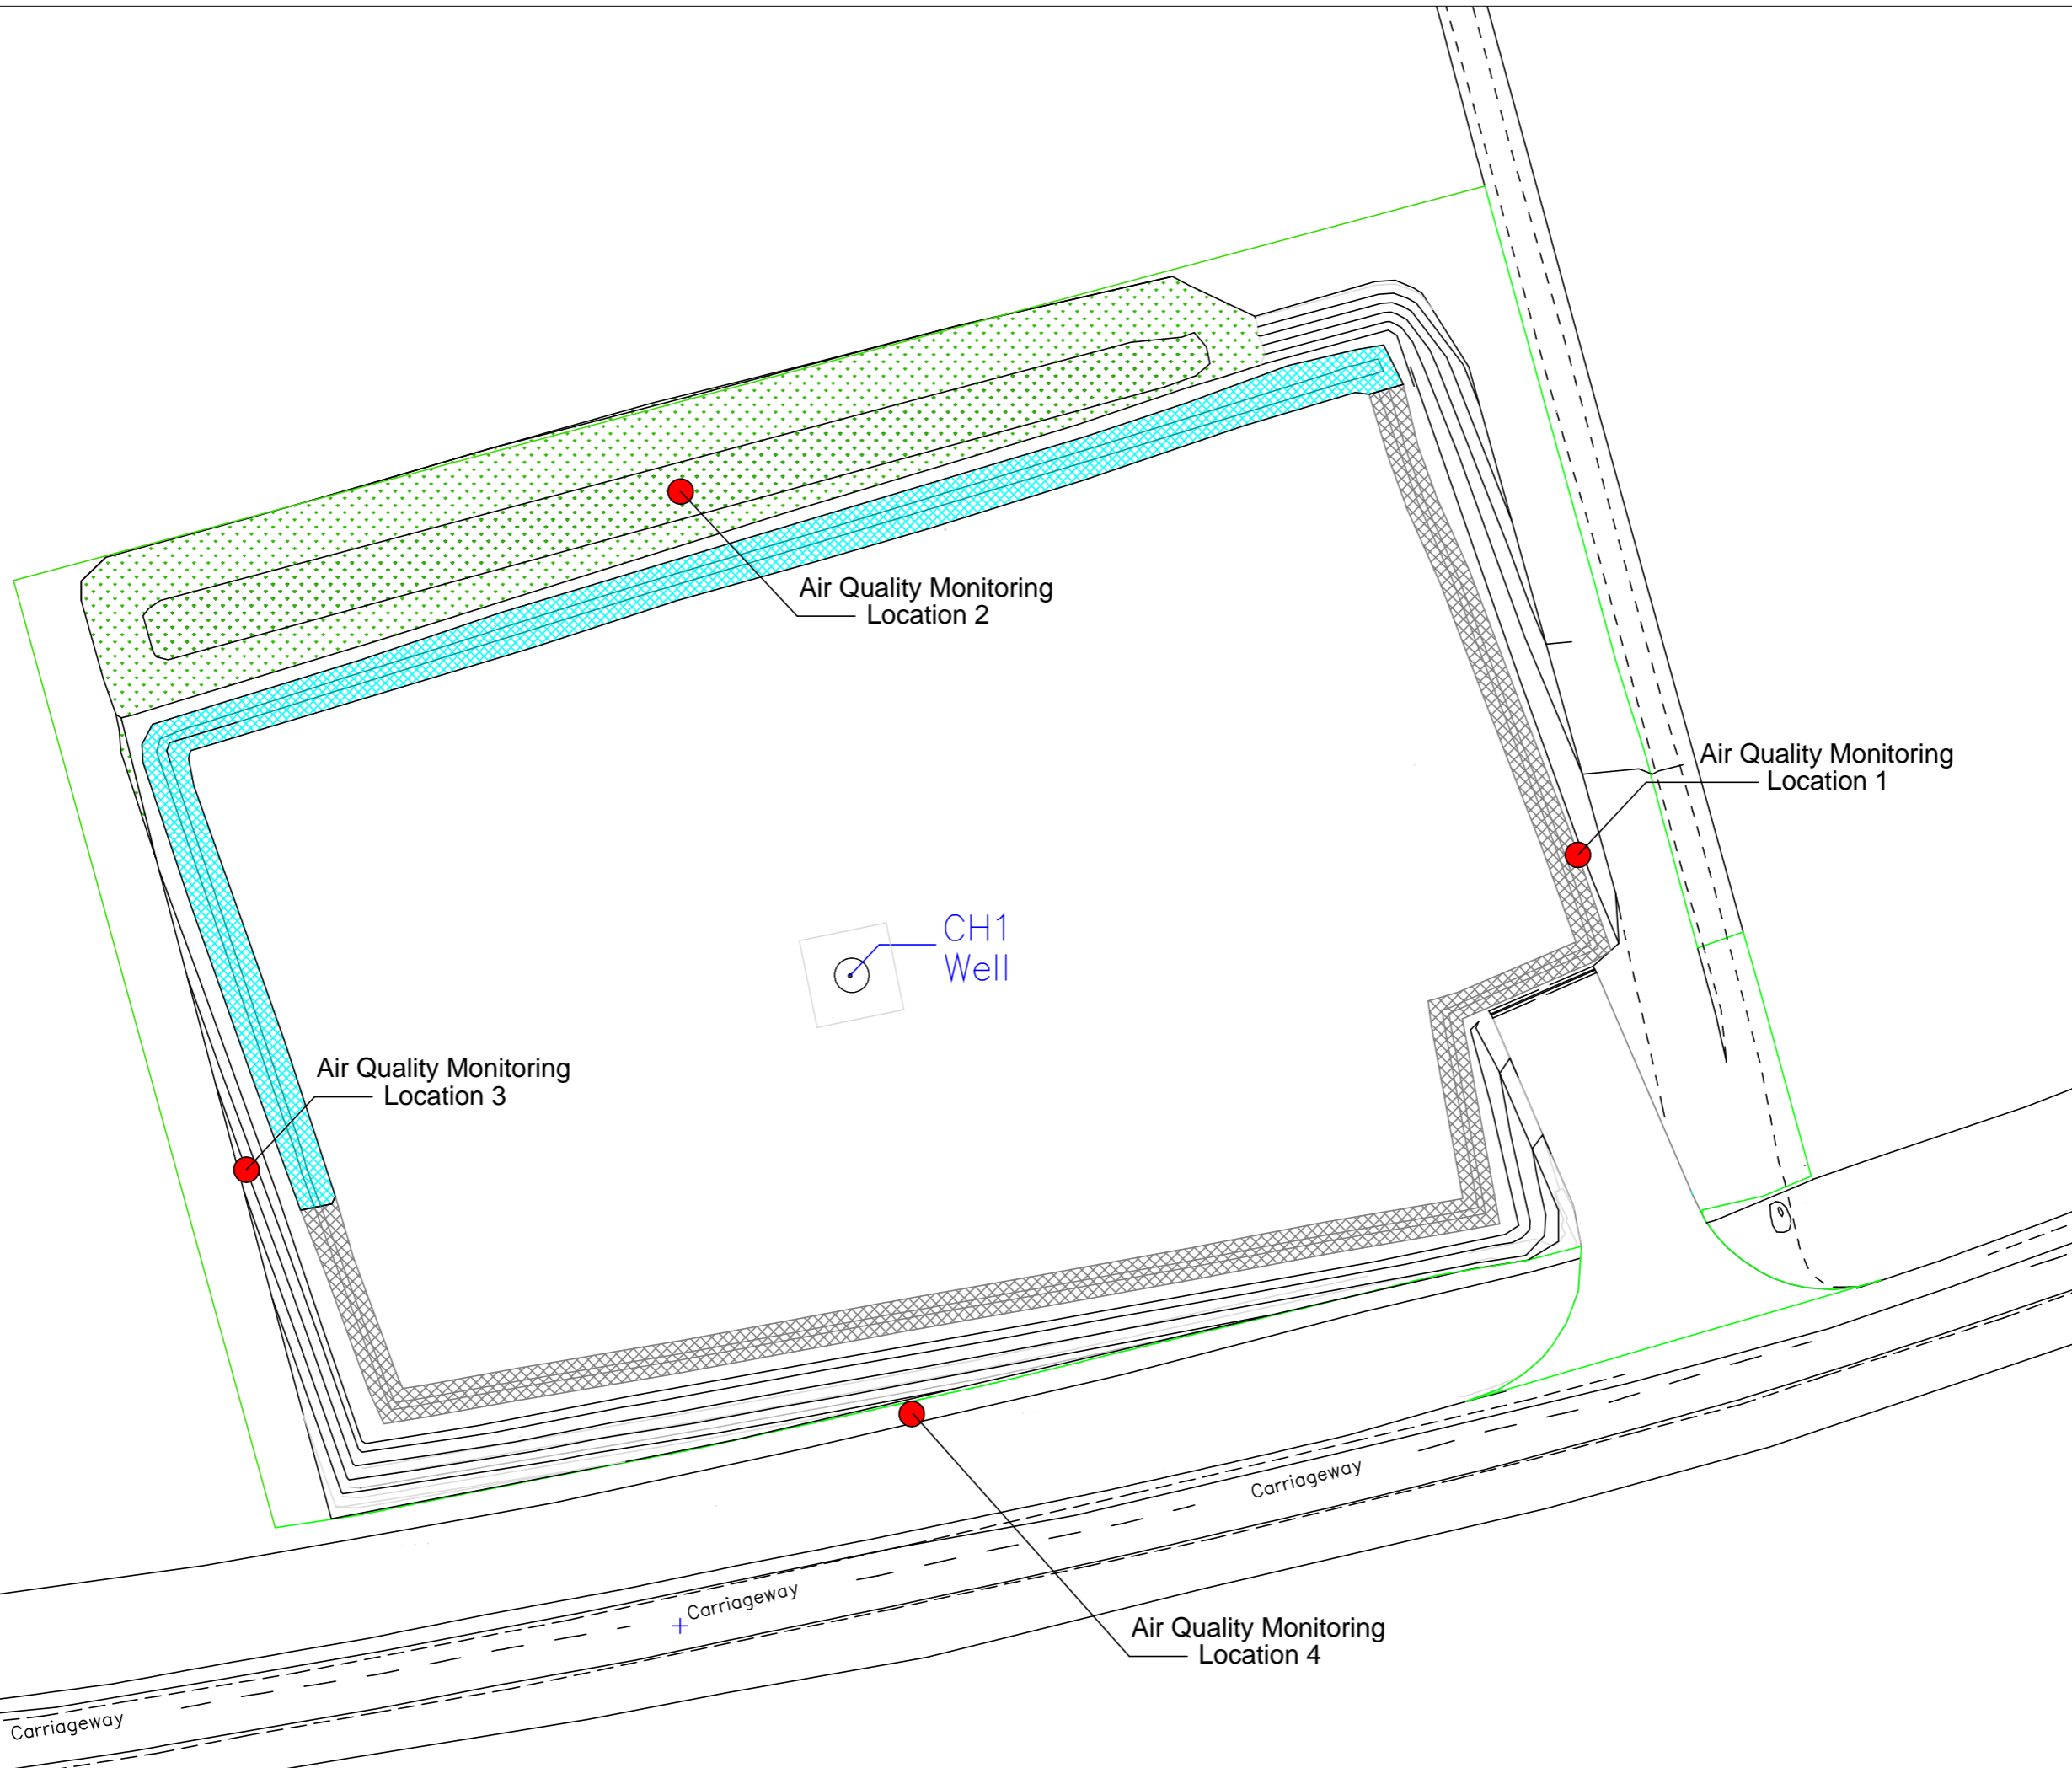

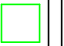

Key:

- Site Boundary 
- Topsoil Storage Bund 
- Open Perimeter Drainage Ditch 
- Piped Perimeter Drainage Ditch 
- Air Quality Monitoring Locations 



Rathlin Energy (UK) Limited
8 Wimpole Street
London
W1G 9SP

Job Title:
Crawberry Hill Wellsite

Drawing Title:
As-Built Plan
(Environmental & waste
Management Plan)

Scale: 1:500 (Print A3)

Date: 16th January 2014

Drawn By:
Jonathan Foster

Drawing No:
RE-05-EPRA-CH-SP-004-02

Rev: 0